




AS BUILT
Esc.: 1:100

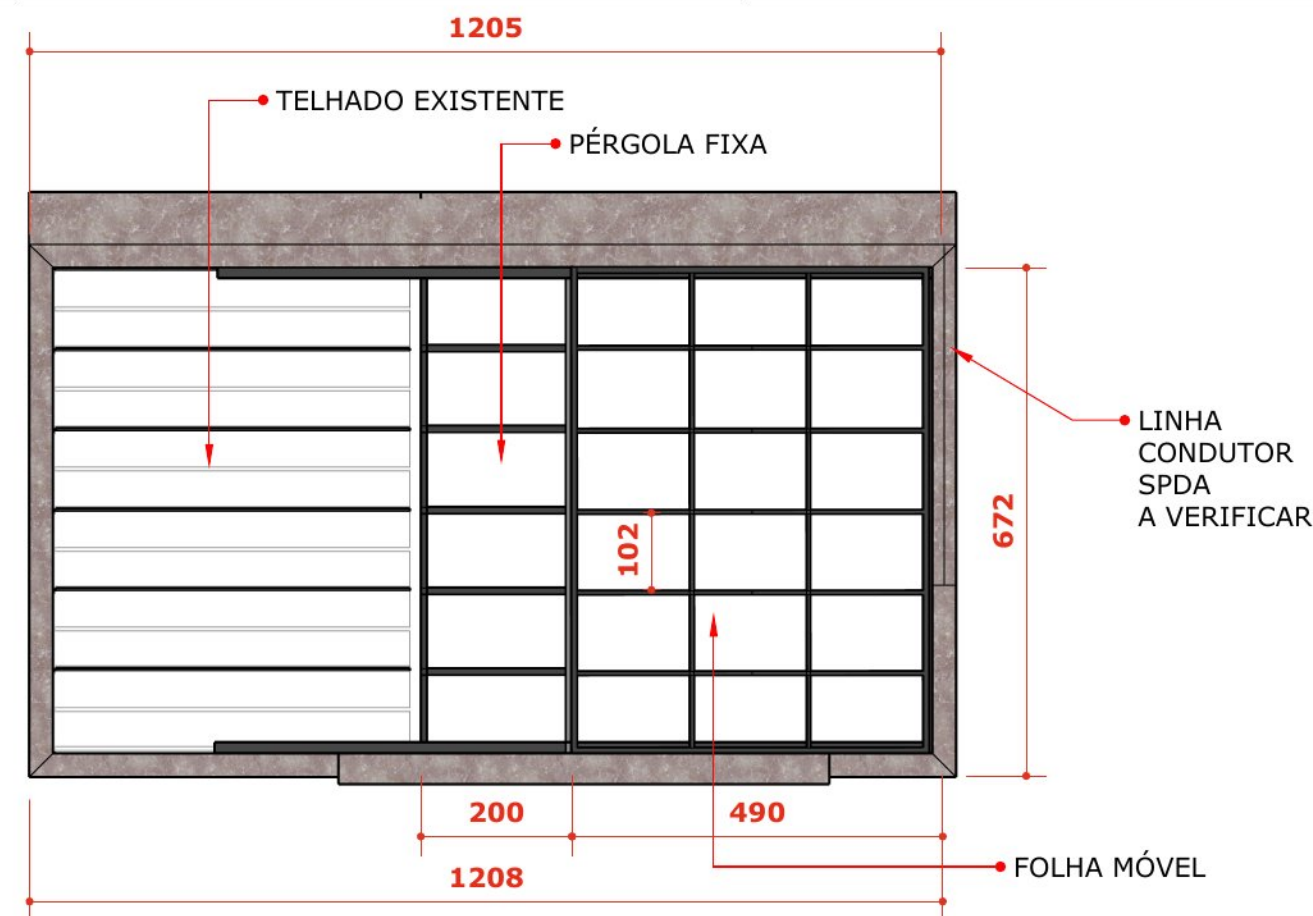


PLANTA EXECUTIVA
Esc.: 1:100
medidas em centímetros

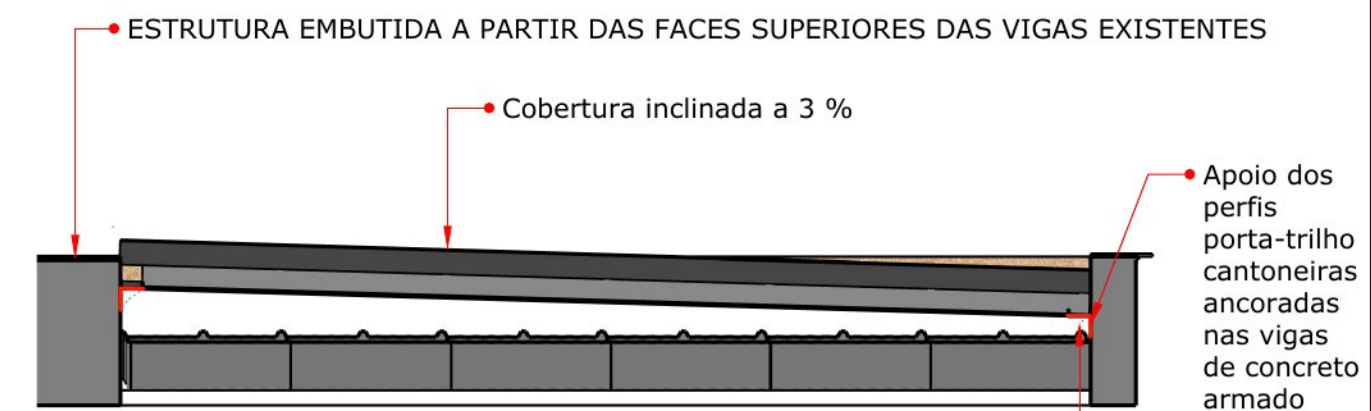


CORTE TRANSVERSAL
Esc.: 1:100

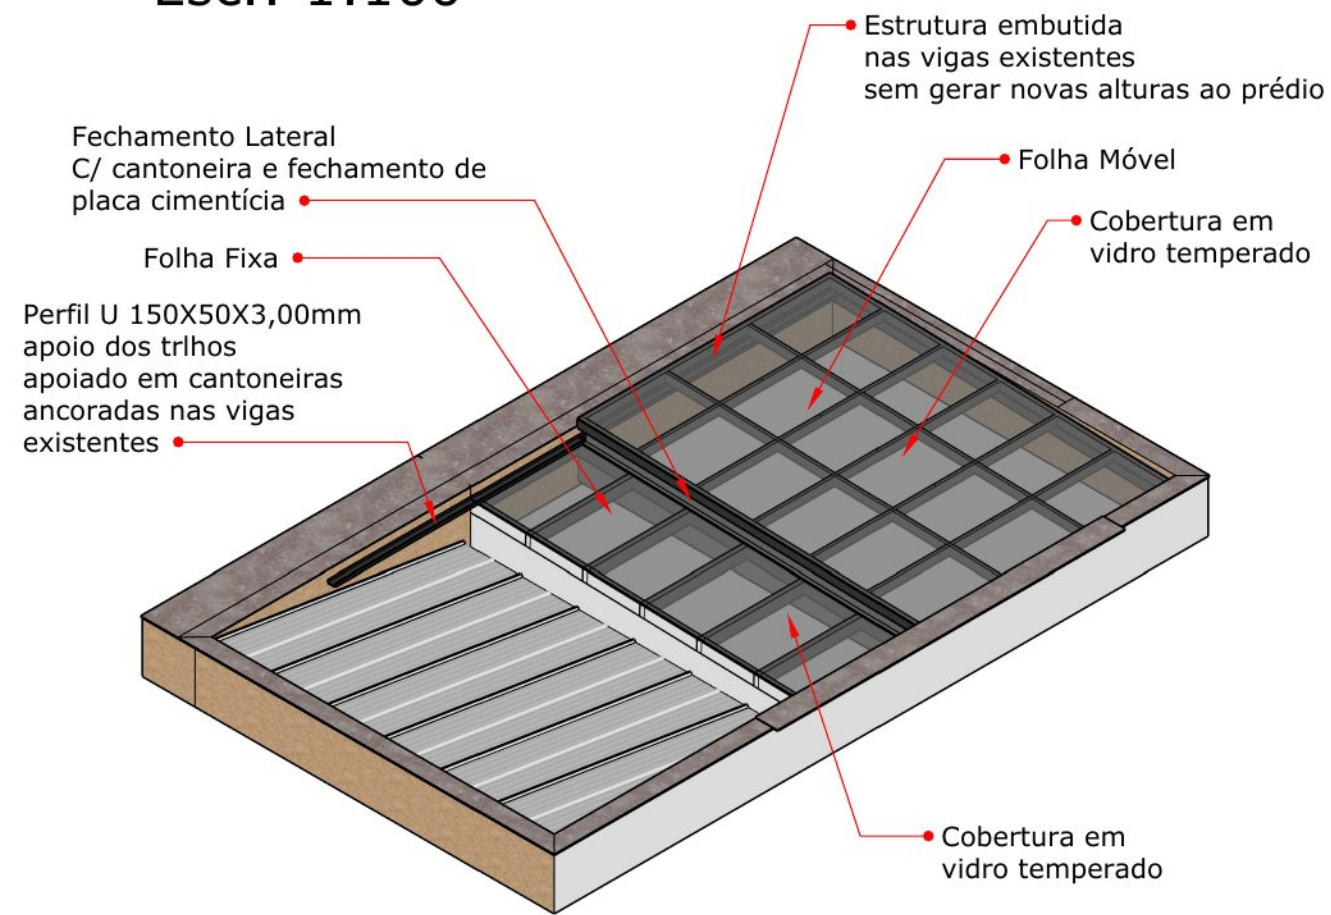


ISO 1
Esc.: 1:100

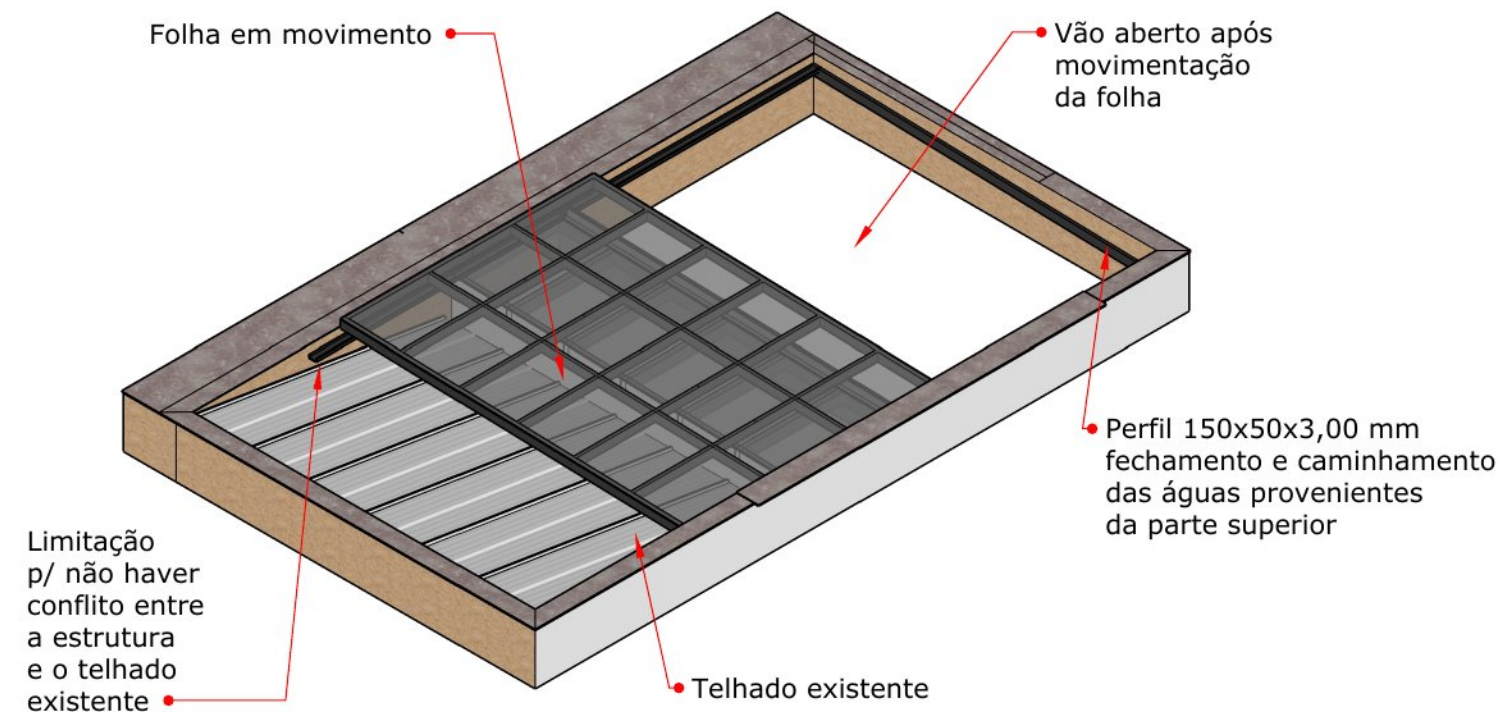

ISO 1 - ABERTO
Esc.: 1:100

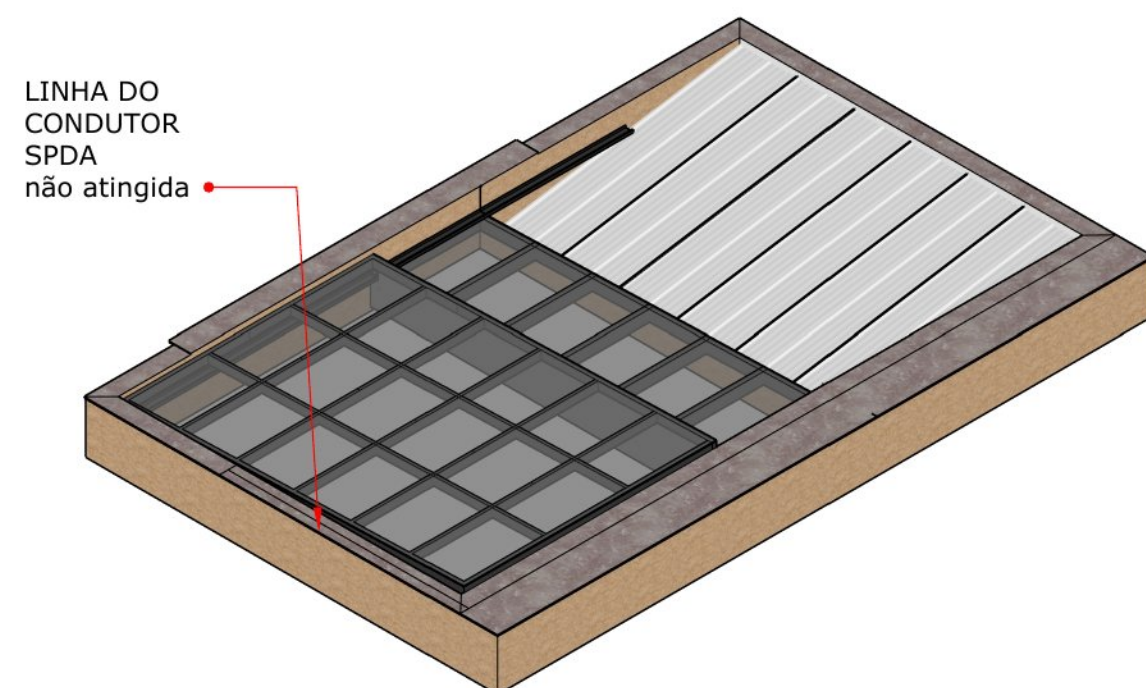

ISO 2
Esc.: 1:100

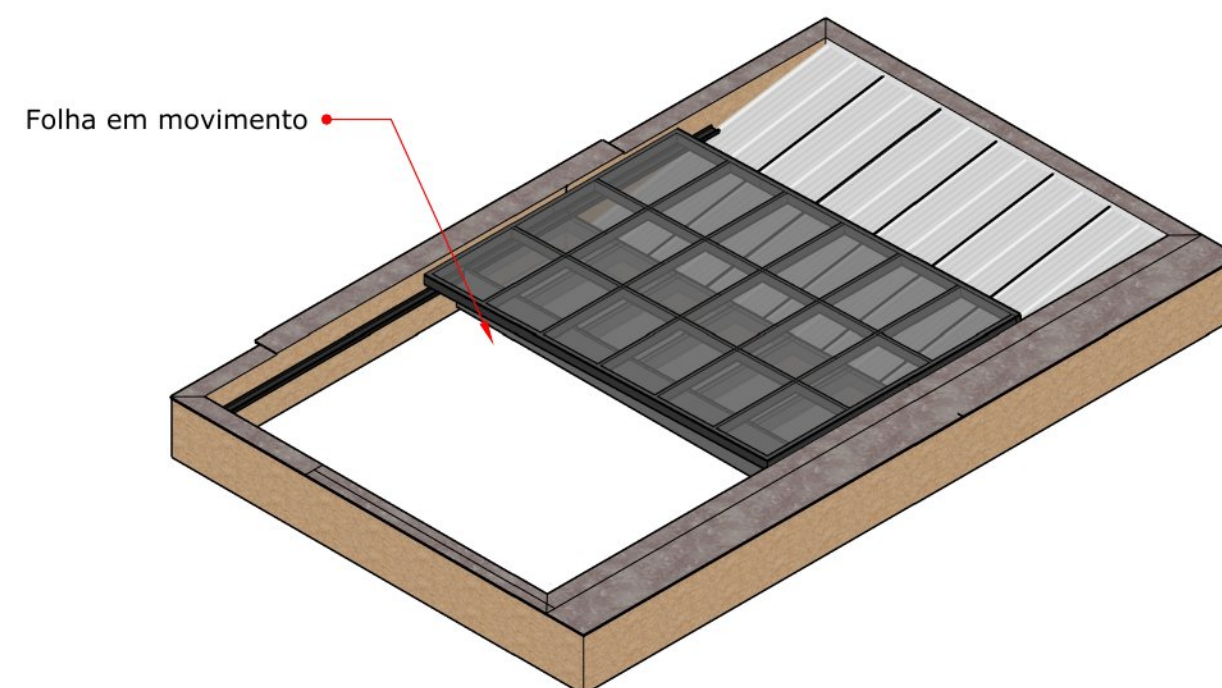

ISO 2 - ABERTO
Esc.: 1:100